




insight
design

1900 N. Bayshore
Drive - #204-A
Miami, Florida
3 3 1 3 2
305.545.4964

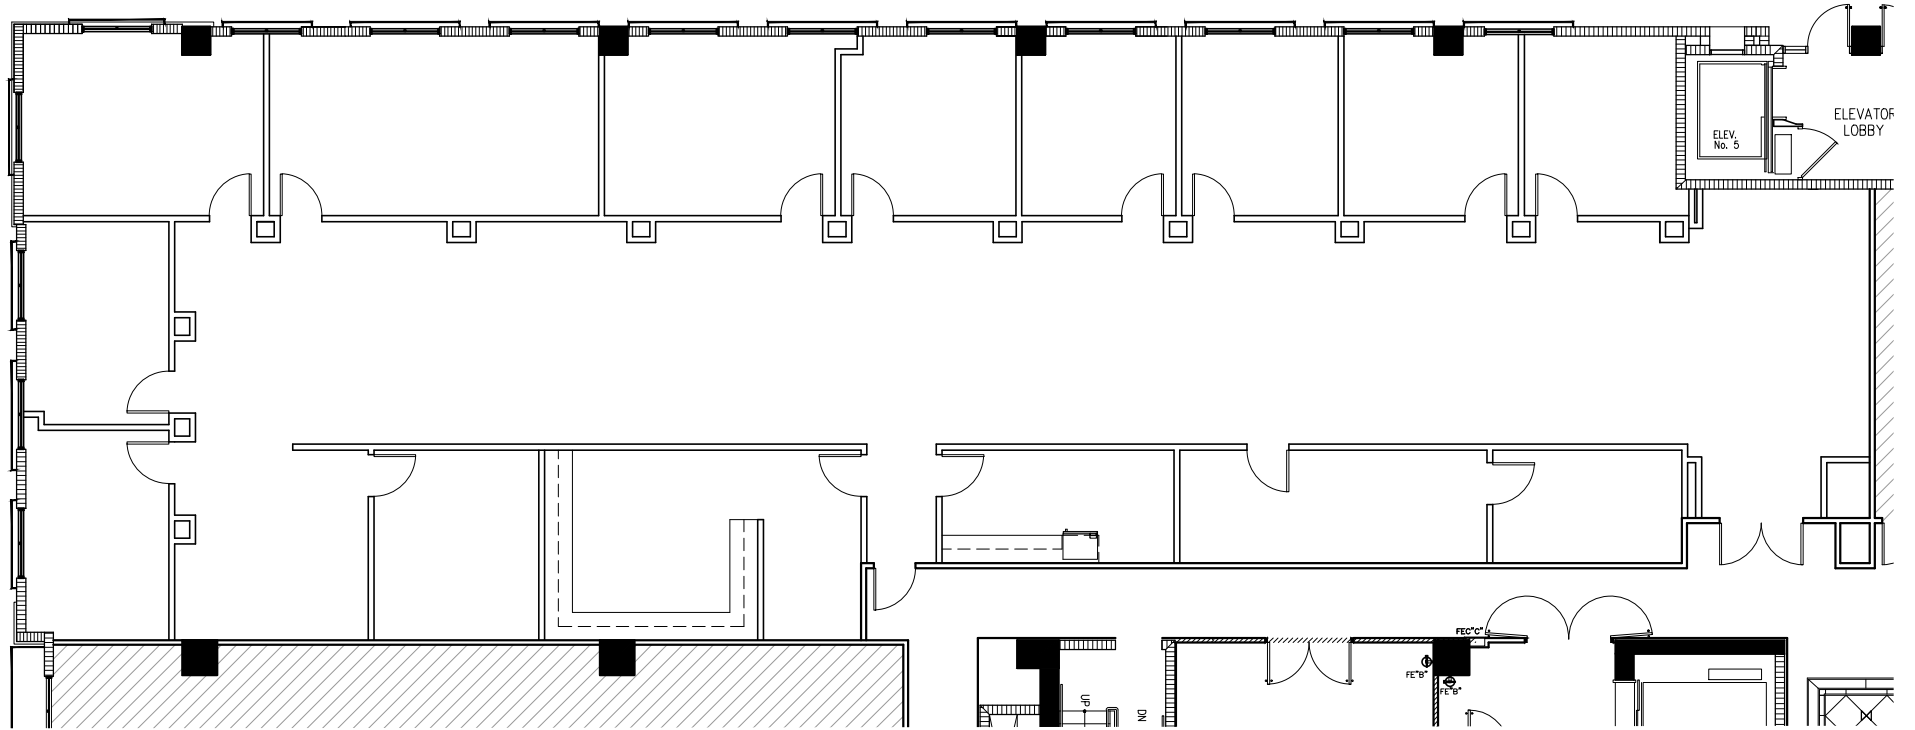

4000 Ponce de Leon

Suite 490 - As Built



PROJECT NO:	1806-00
DRAWN BY:	I.G.
DATE:	01/29/2020
SCALE:	N.T.S.
SHEET NO:	SK-1