




insight
design

1900 N. Bayshore
Drive - #204-A
Miami, Florida
3 3 1 3 2
305.545.4964

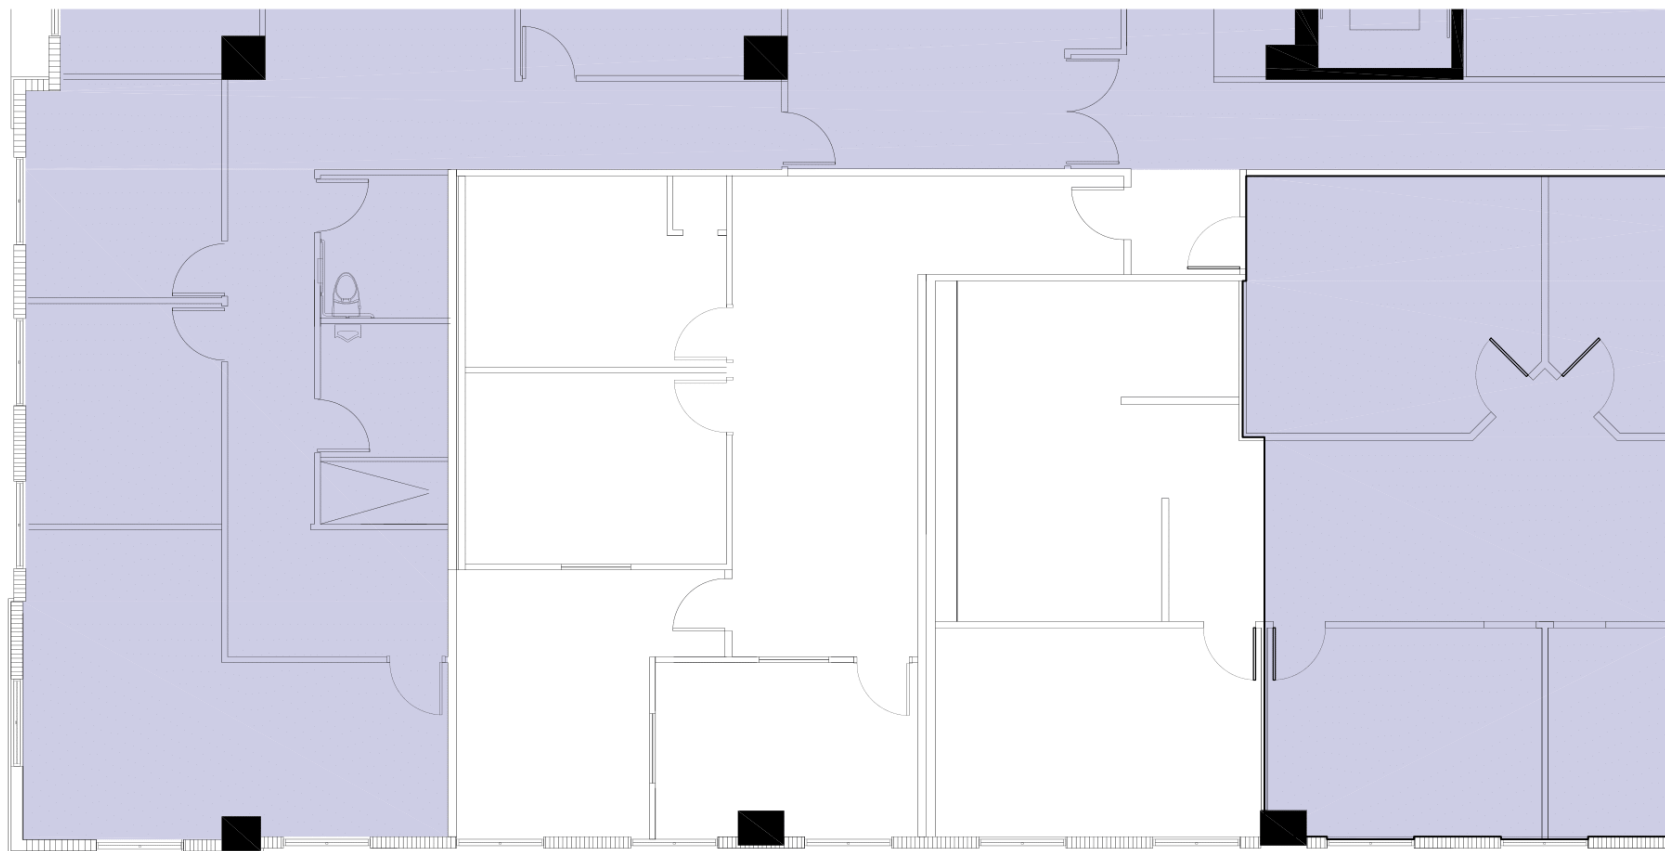

4000 Ponce de Leon

As-Built Plan / Suite 780

7TH FLOOR



PROJECT NO:	1806-00
DRAWN BY:	I.M.
DATE:	05/13/20
SCALE:	N.T.S.
SHEET NO:	SK-1